



WAWONA HOUSING AREA
 CONCESSIONER LAND ASSIGNMENT MAP NO. 37
 YOSEMITE NATIONAL PARK

EXHIBIT C - 3
 CC-YOSE004-93
 MAP PAGE 40 OF 40

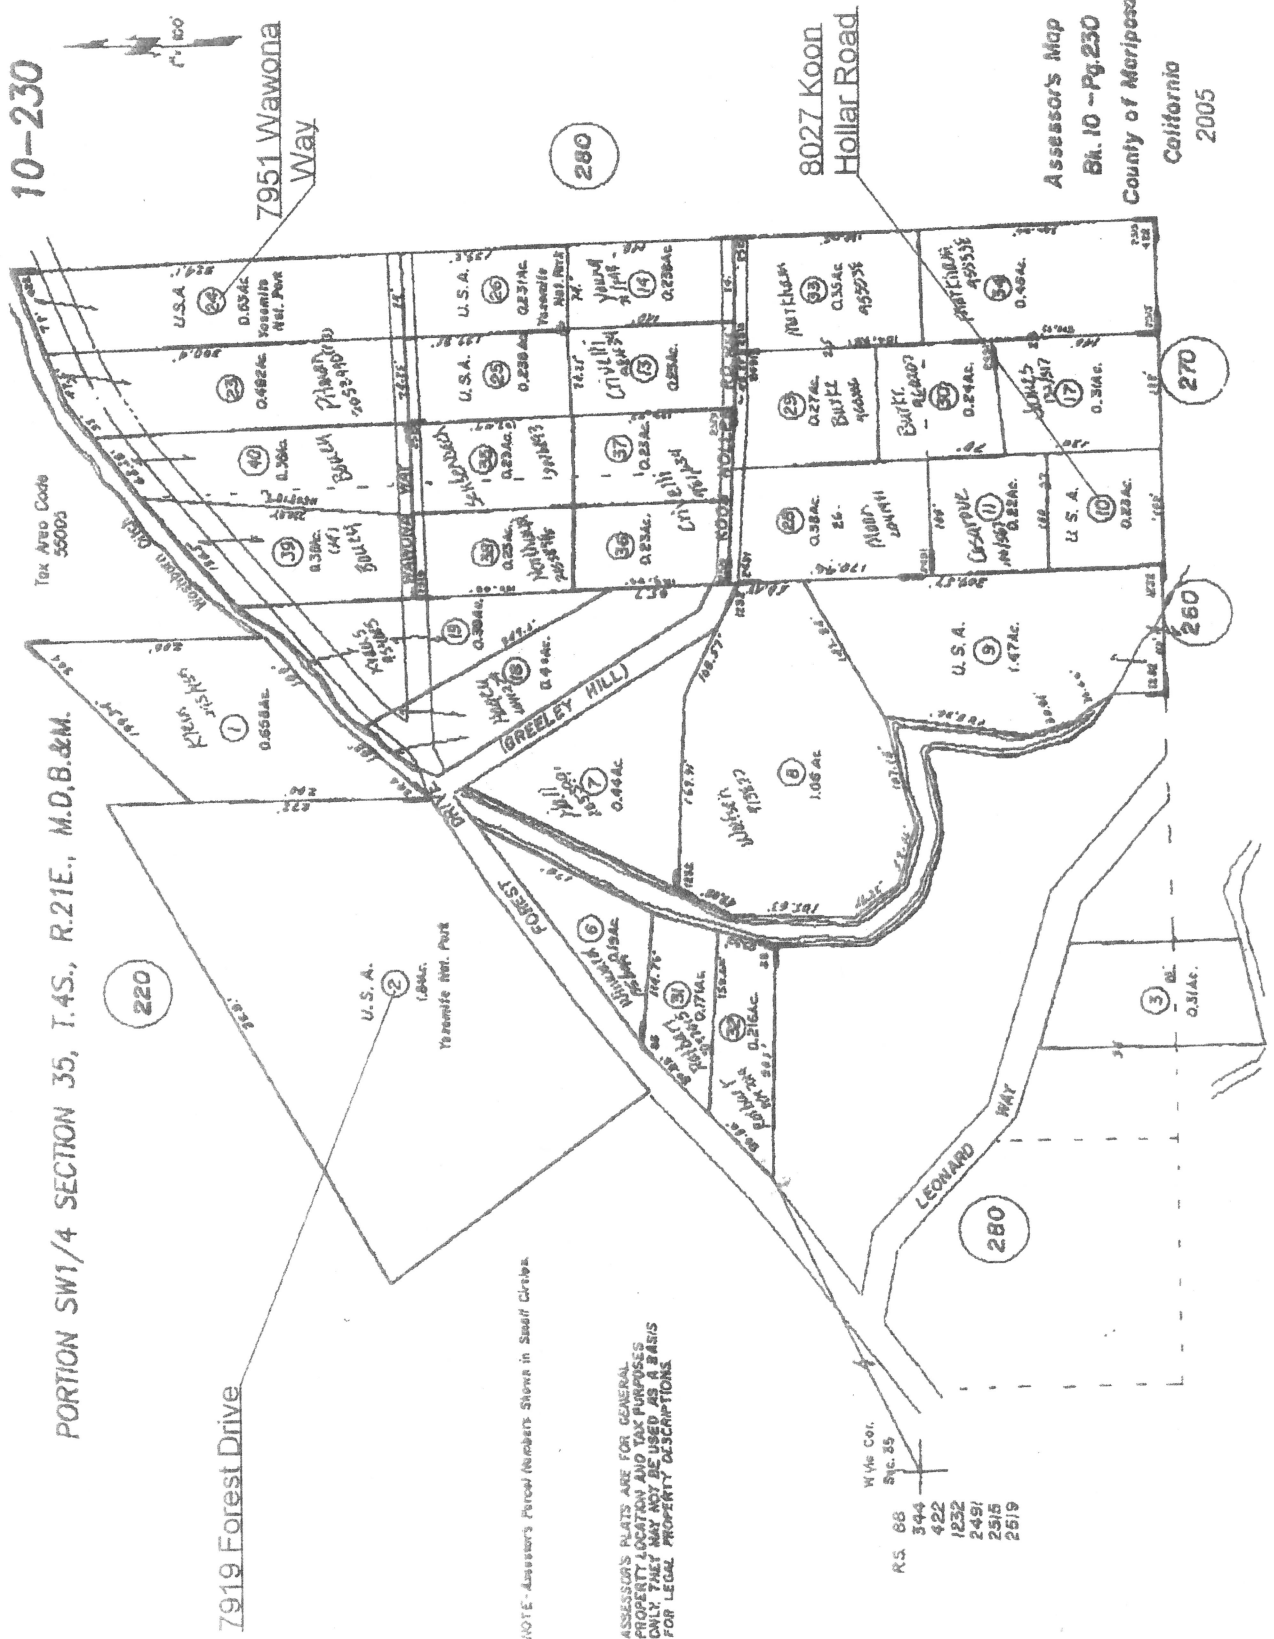


Assessor's Map
 Bl. 10 - Pg. 230
 County of Mariposa
 California
 2005

EXHIBIT C - 3
CC-YOSE004-93
MAP PAGE 5 OF 40

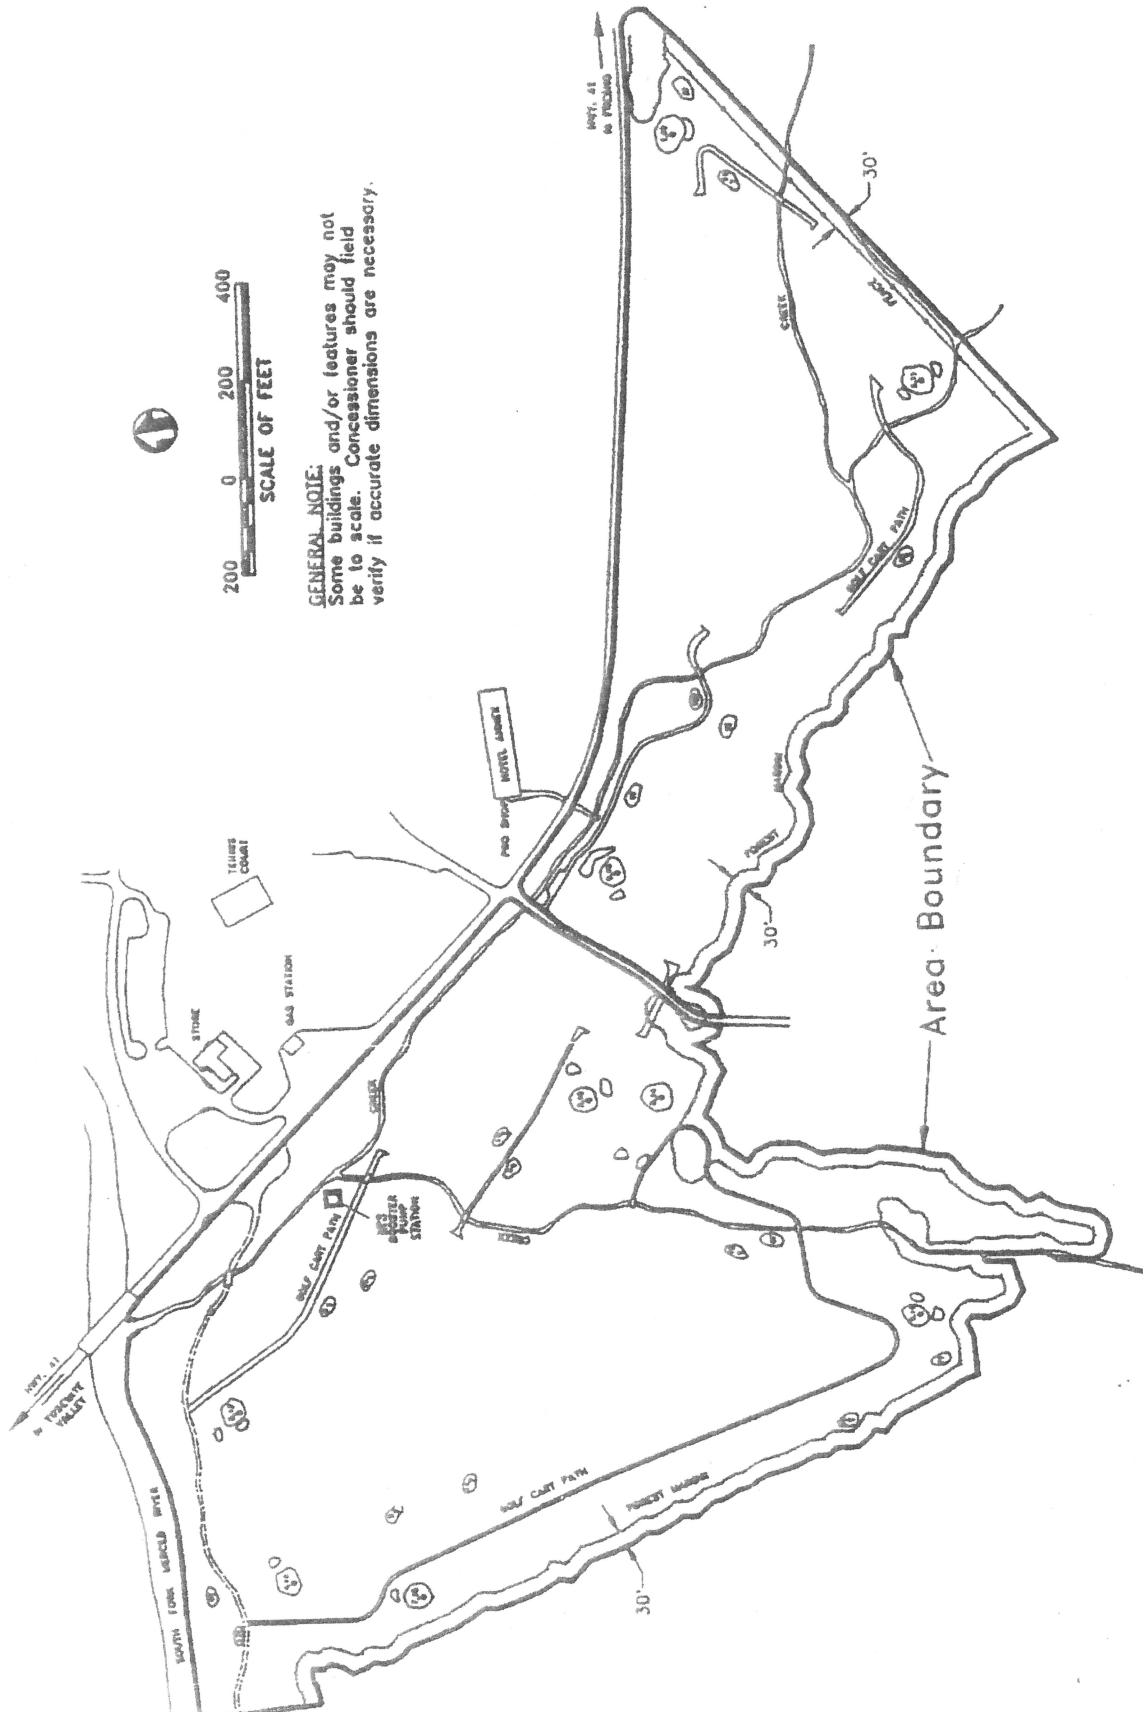

WAWONA HOTEL COMPLEX
CONCESSIONER LAND ASSIGNMENT MAP NO.2
YOSEMITE NATIONAL PARK

EXHIBIT C - 3
CC-YOSE004-93
MAP PAGE 4 OF 40

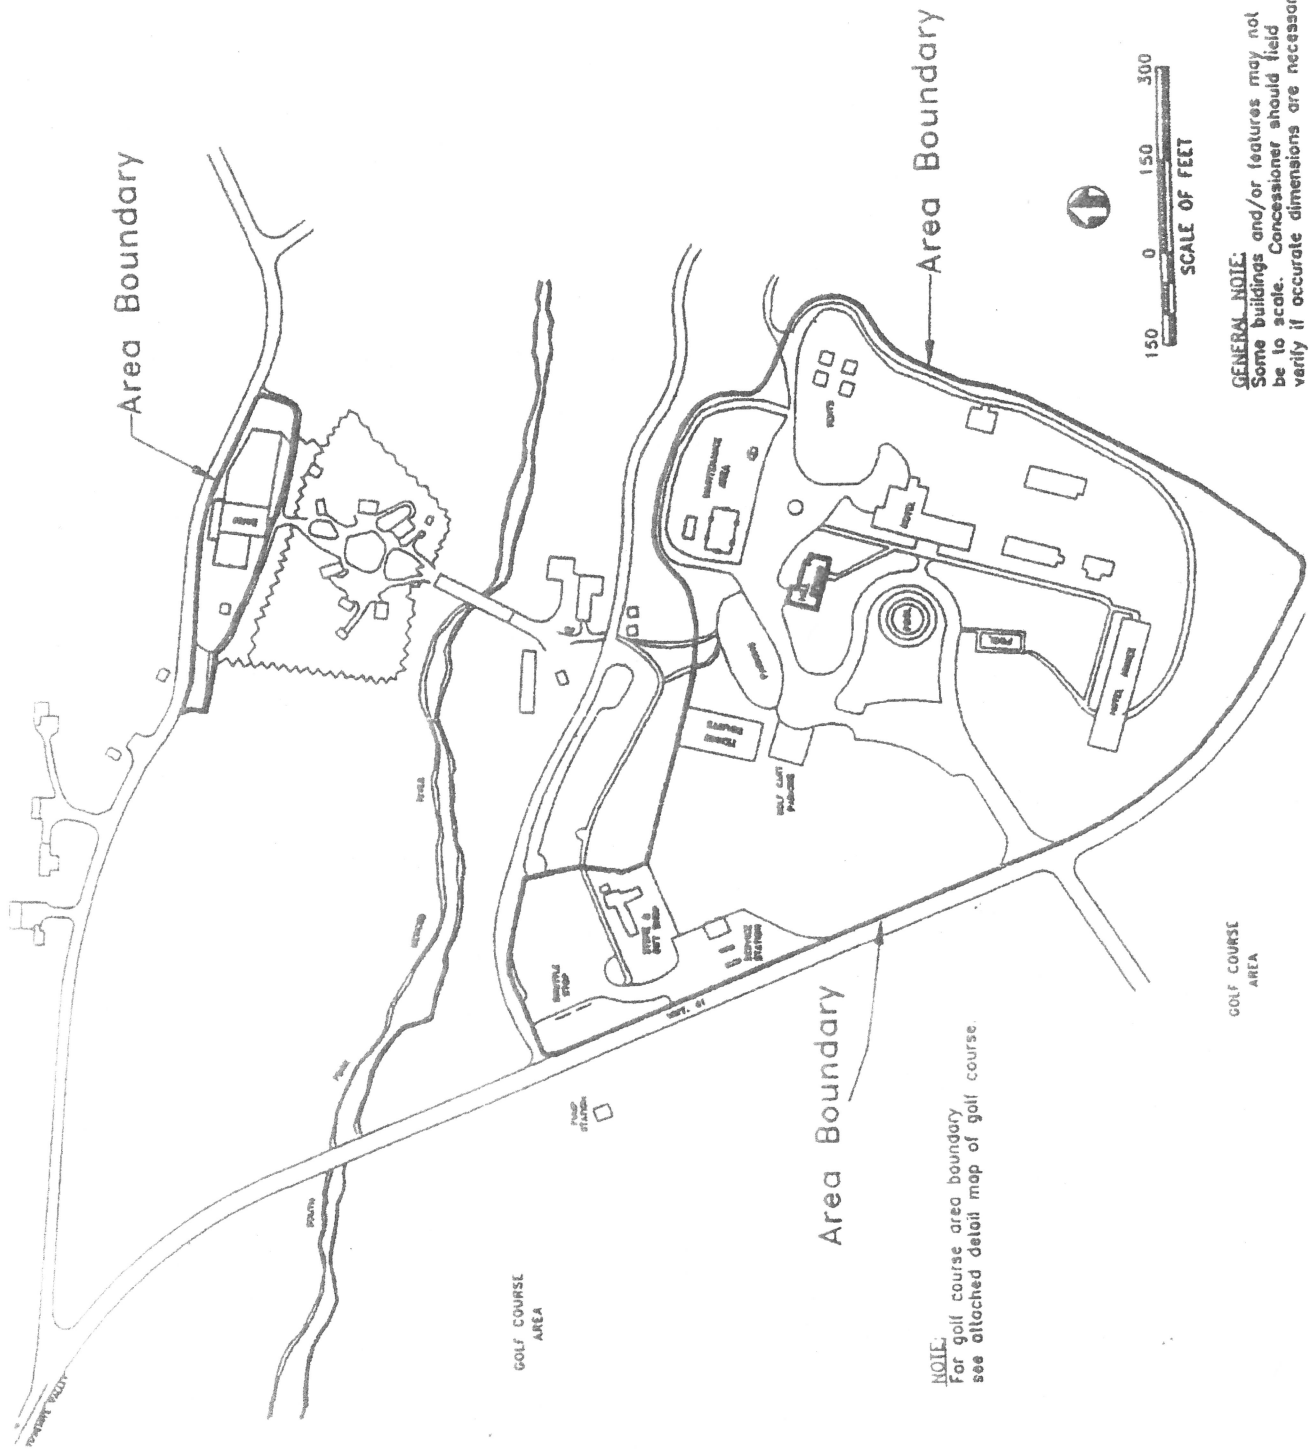

GENERAL NOTE:
Some buildings and/or features may not
be to scale. Concessioner should field
verify if accurate dimensions are necessary.

NOTE:
For golf course area boundary
see attached detail map of golf course

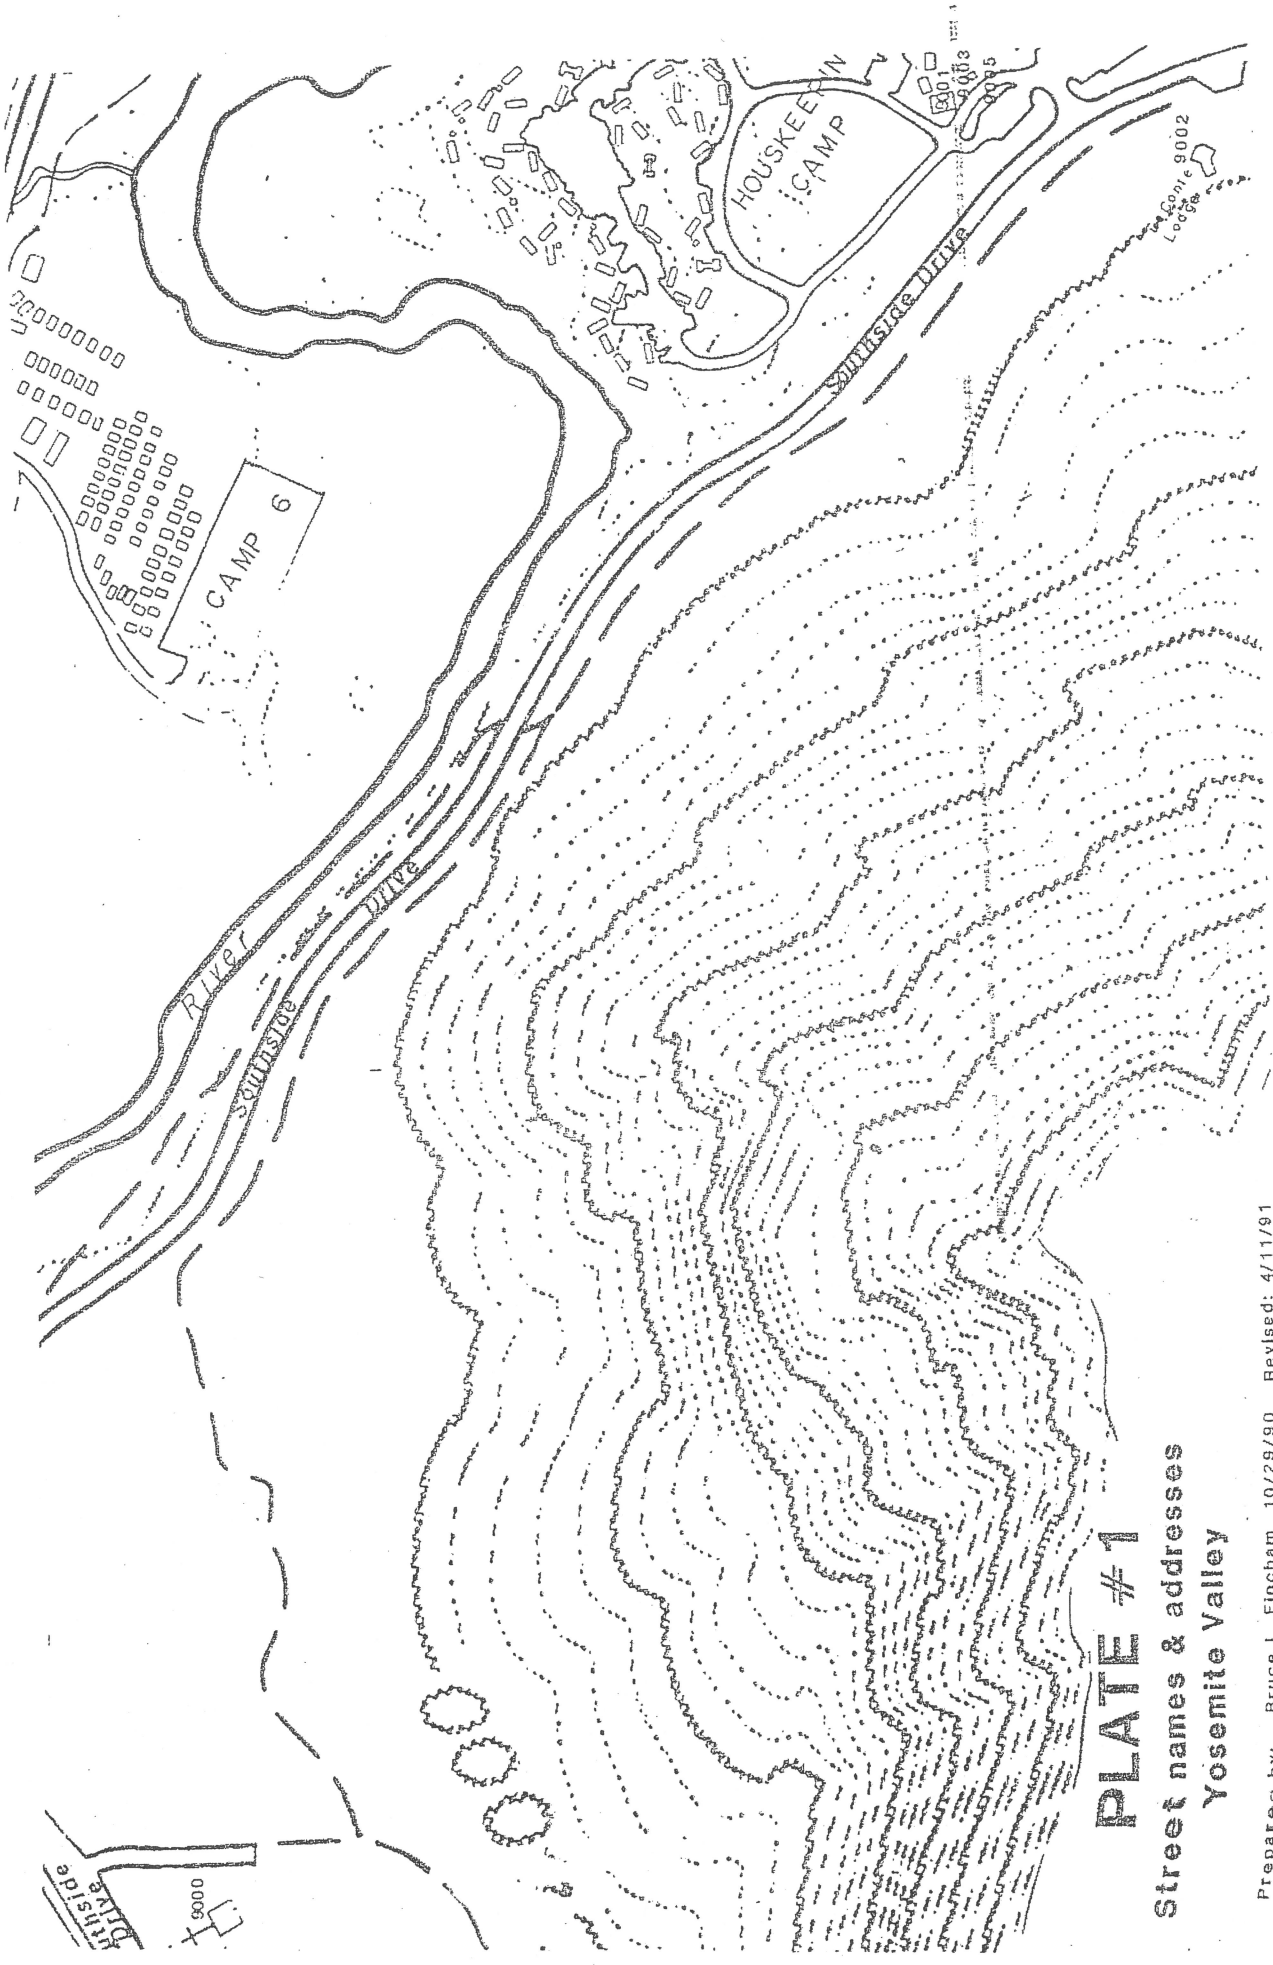


PLATE #1
Street names & addresses
Yosemite Valley

Prepared by: Bruce L. Fincham 10/29/90 Revised: 4/11/91

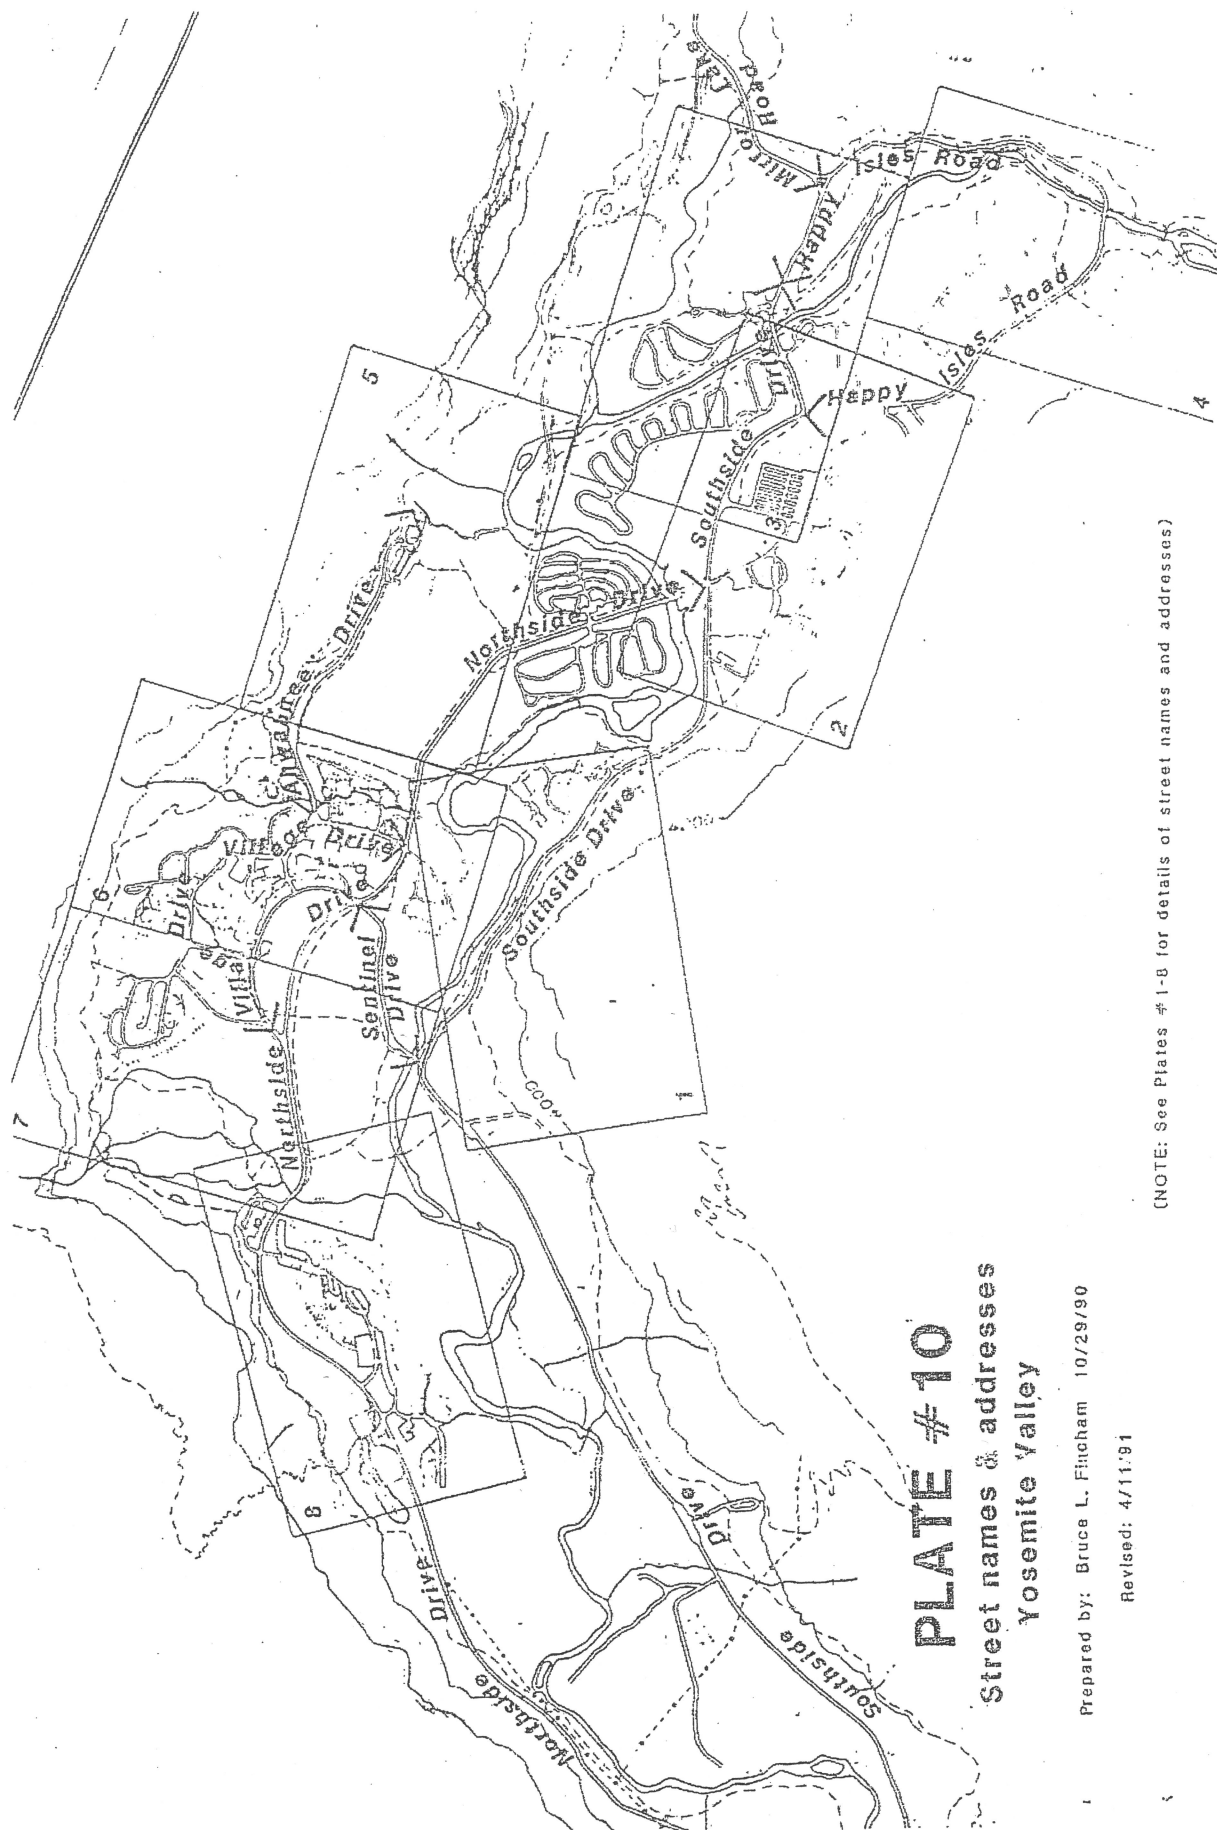





PLATE #10 **Street names & addresses** **Yosemite Valley**

Prepared by: Bruce L. Fincham 10/29/90


Revised: 4/11/91

(NOTE: See Plates # 1-8 for details of street names and addresses)

THE AHWAHNEE COTTAGES

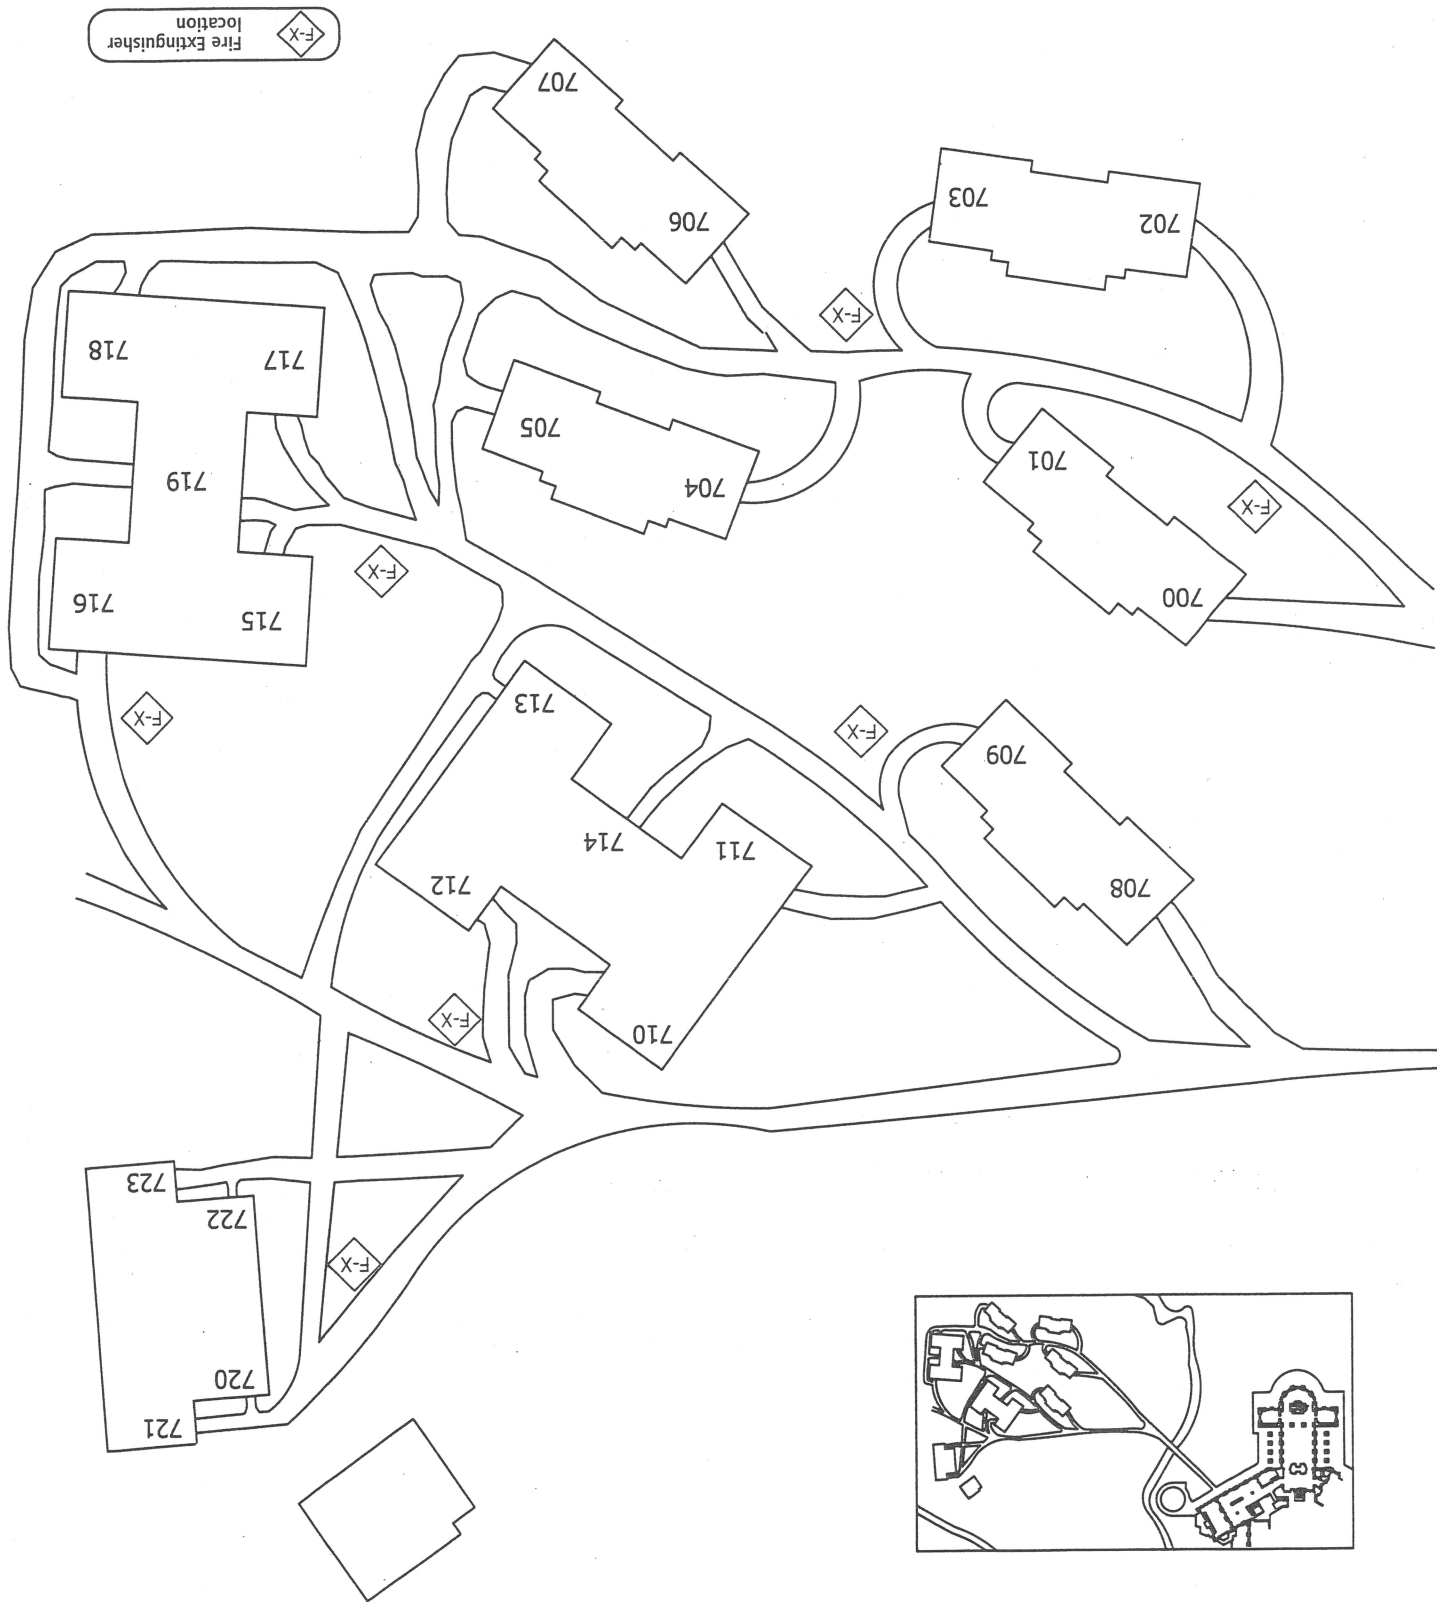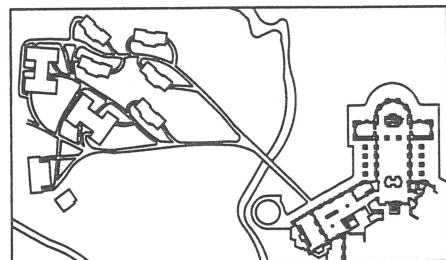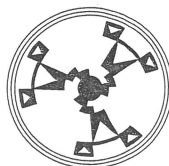

Fire Extinguisher
location

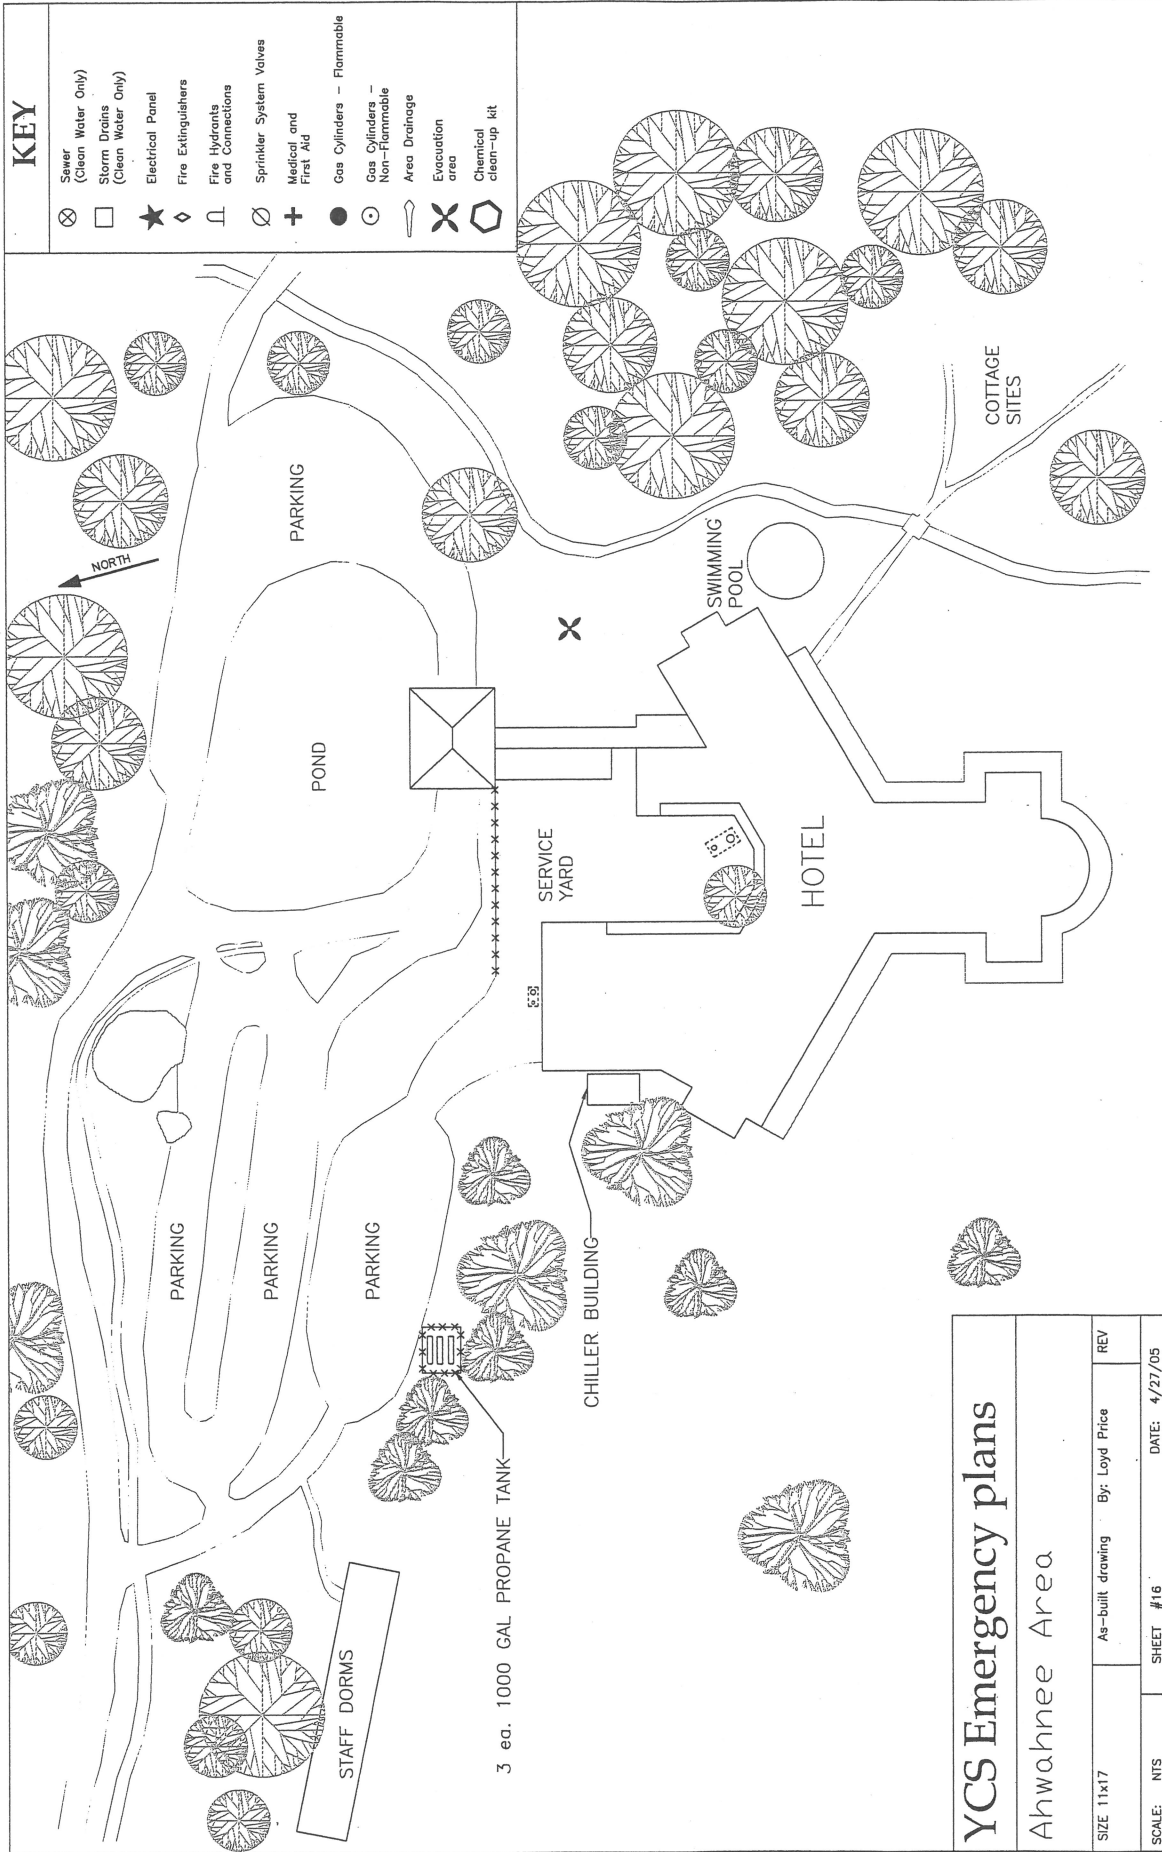


YCS Emergency plans

Ahwahnee Area

SIZE 11x17	As-built drawing	By: Loyd Price	REV
SCALE: NTS	SHEET #16	DATE: 4/27/05	

KEY	
⊗	Sewer (Clean Water Only)
□	Storm Water (Clean Water Only)
★	Electrical Panel
◇	Fire Extinguishers
⊥	Fire Hydrants and Connections
⊘	Sprinkler System Valves
+	Medical and First Aid
●	Gas Cylinders - Flammable
○	Gas Cylinders - Non-Flammable
⌒	Area Drainage
✕	Evacuation area

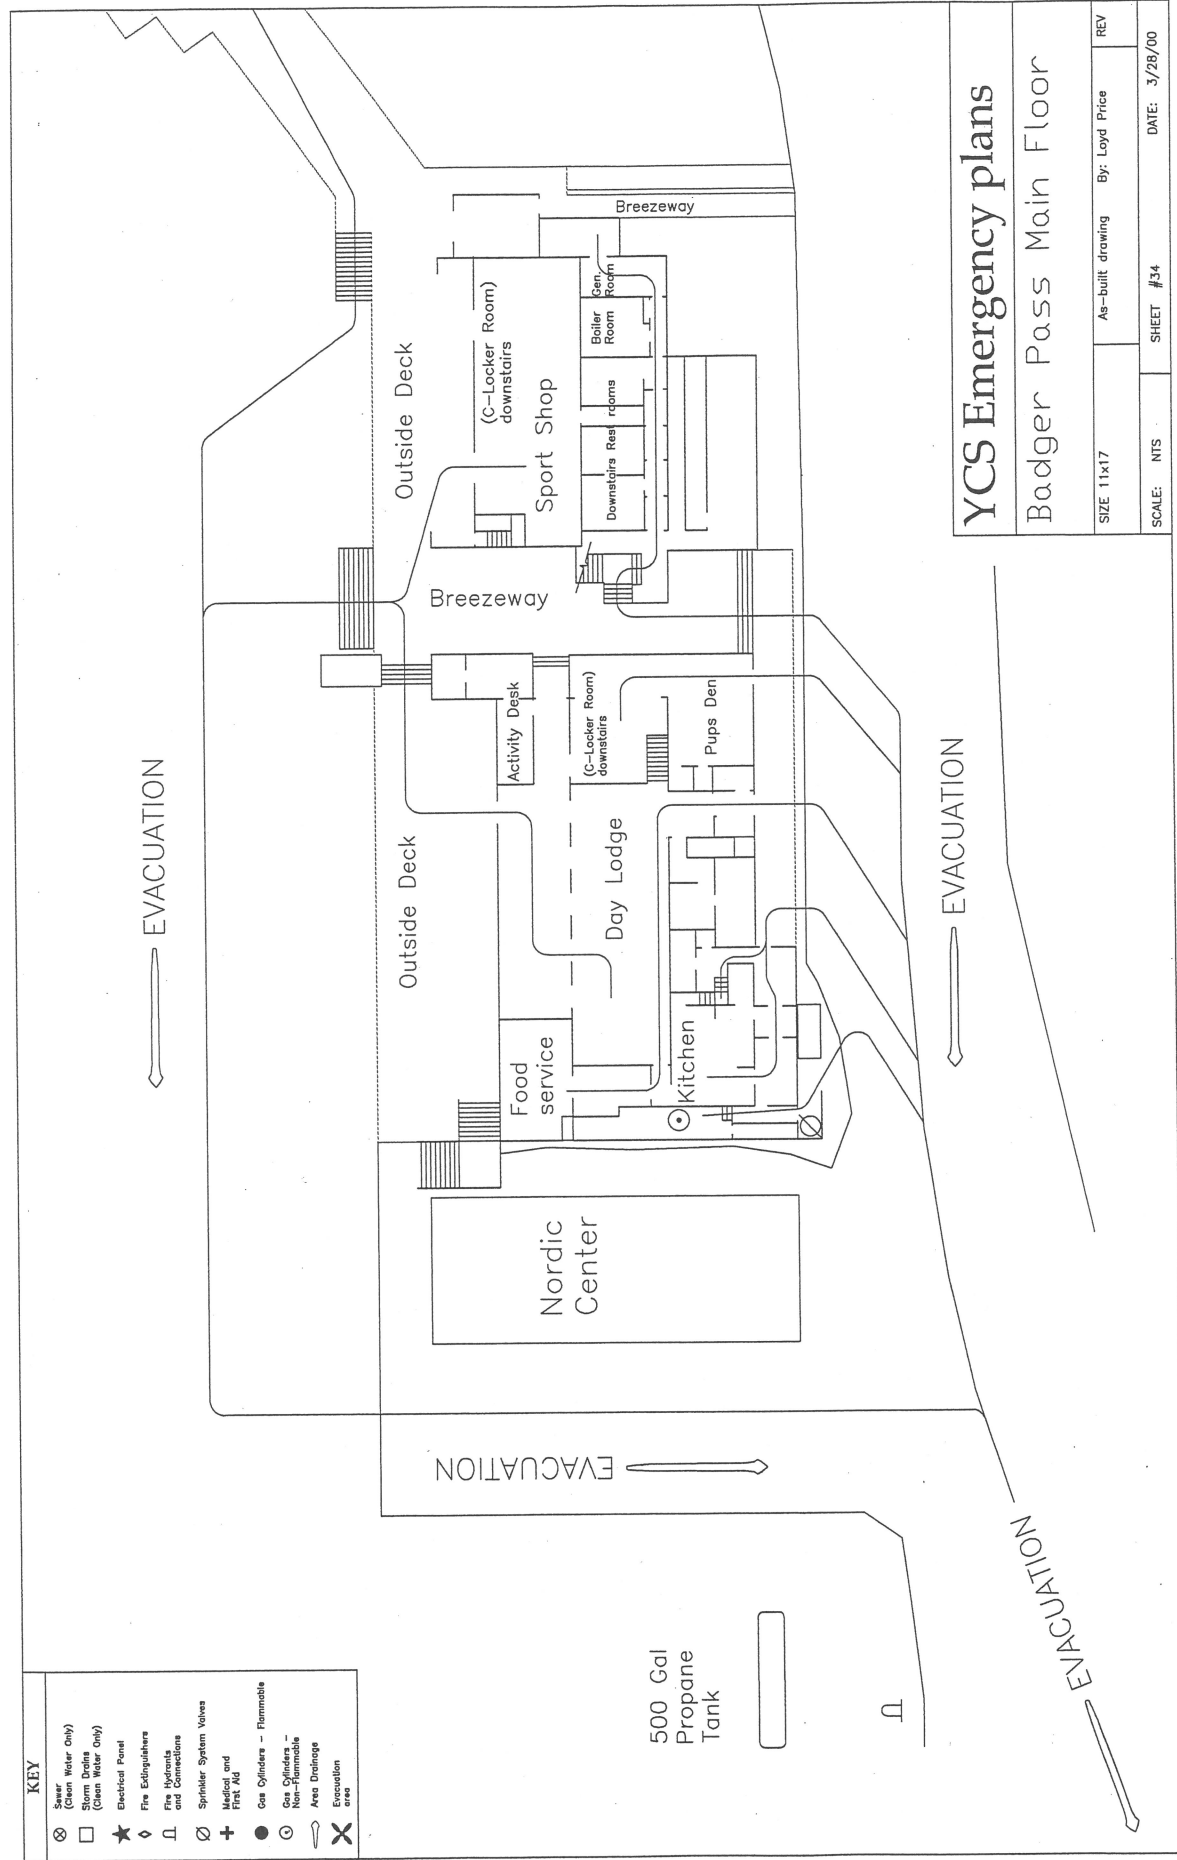

YCS Emergency plans			
Badger Pass Main Floor			
SIZE 11x17	As-built drawing	By: Loyd Price	REV
SCALE: NTS	SHEET #34	DATE: 3/28/00	


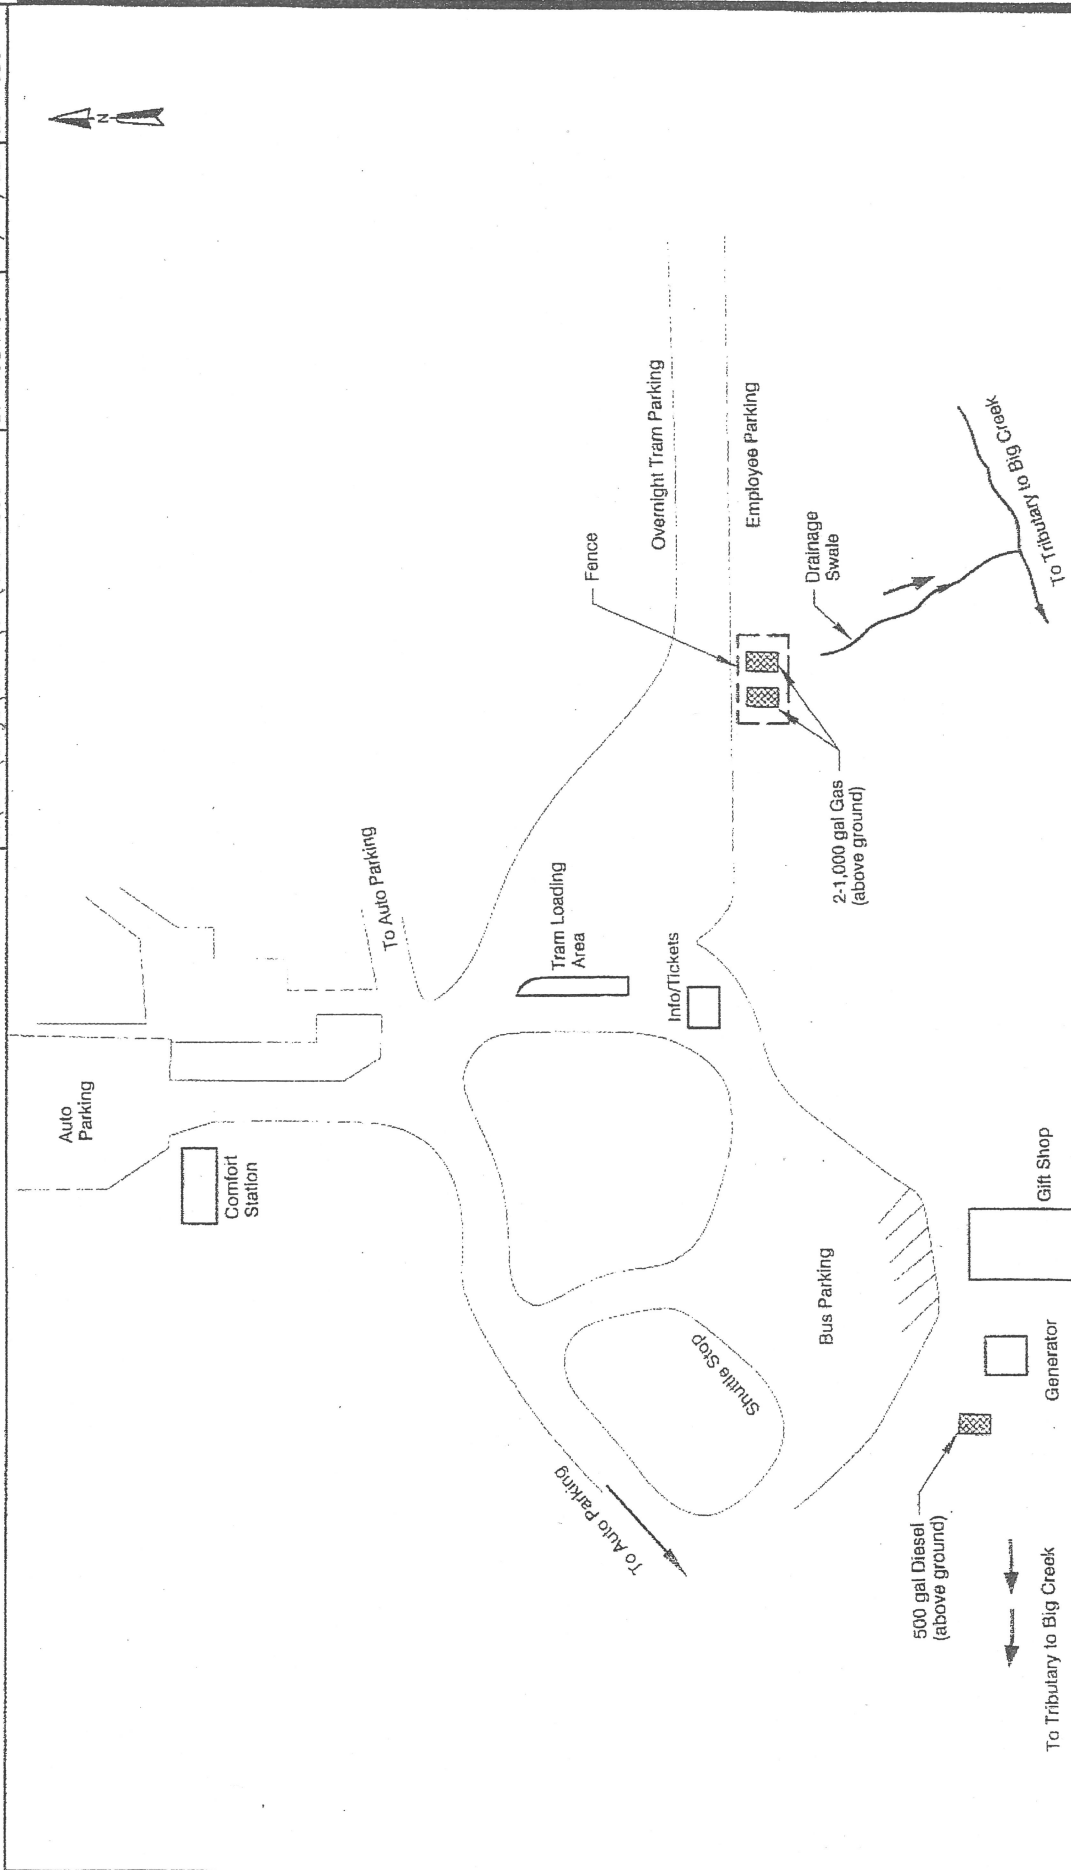


Figure 3-1
 Big Tree Site Plan
 Yosemite Concession Services Corporation
 Yosemite, California



BOYSTOWN

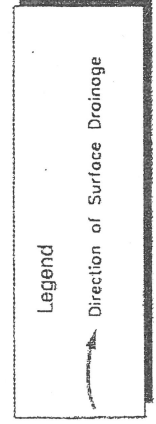